


# REFERENCE DWGS:

4850AE044G  
4850AE082A  
4850AE112A  
4850AE113A  
4850AE050C  
4850AE051E


LOGIC AND PANEL WIRING DIAGRAMS

# SHEET NOTES


1. EXTEND (E) CIRCUIT TO NEW FIXTURE AND CONNECT COMPLETE.
2. INSTALL (N) CONDUIT & WIRING AND TIED TO (E) LIGHT CIRCUIT.
3. FIRE ALARM CONNECTION TO MAGNETIC DOOR HOLDER.
4. PROVIDE EXTENSION RING AT (E) SMOKE DETECTOR JUNCTION BOX TO INTERCEPT NEW CONDUIT AND WIRING. USE (E) ZONE 2B15.
5. REMOVE (E) DOOR HOLDER, CONDUIT AND WIRING UP TO THE (E) SMOKE DETECTOR TO REMAIN.
6. REMOVE AND RE-INSTALL (E) LIGHT FIXTURE.
7. BREAK (E) FA ZONE 2B15 LOOP WIRING AND INTERCEPT (N) WIRING.
8. REMOVE (E) DOOR HOLDER. INSTALL NEW DOOR HOLDER WITH INTERNAL SMOKE DETECTOR. NORTON PTD-24

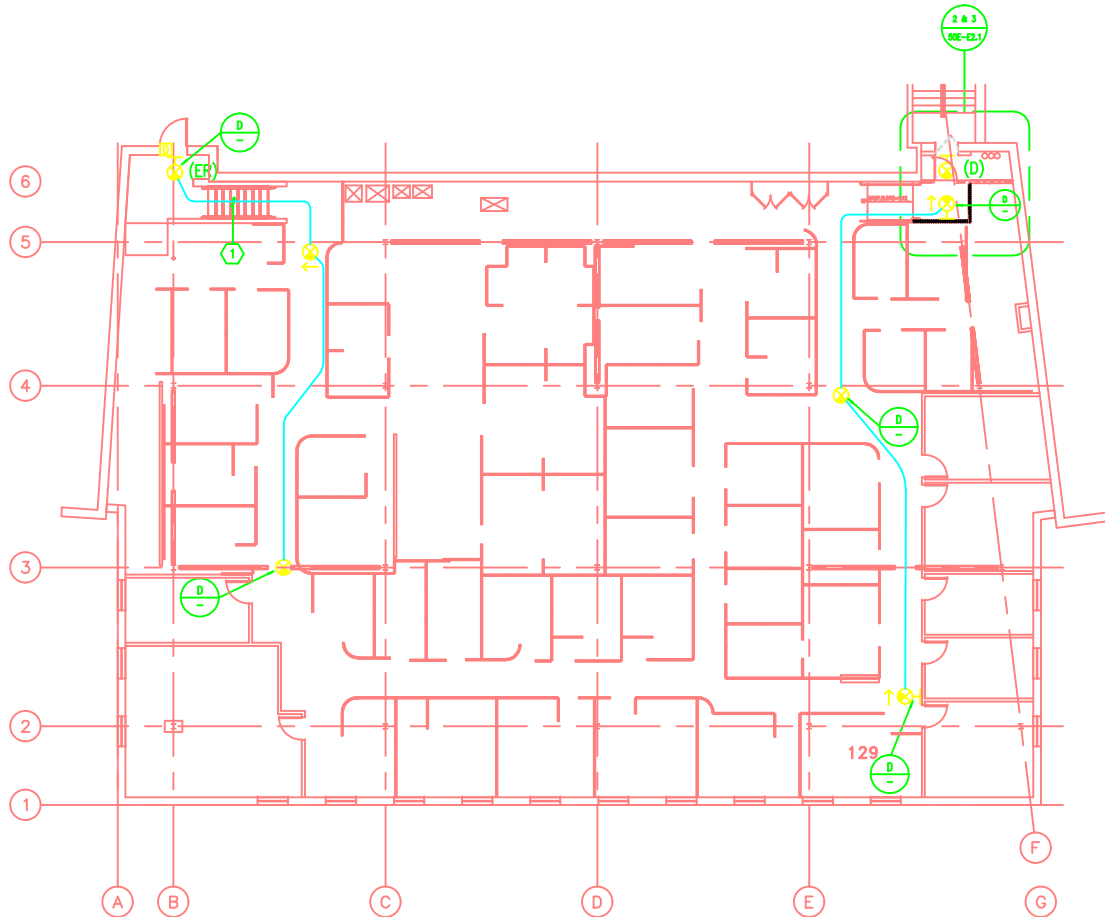

2 FIRST FLOOR PARTIAL PLAN-LTG.  
SCALE: 1/8"=1'-0"

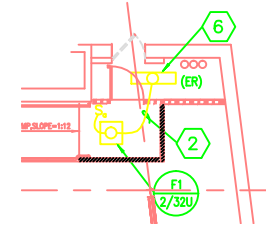

3 FIRST FLOOR PARTIAL PLAN-SIGNAL  
SCALE: 1/8"=1'-0"

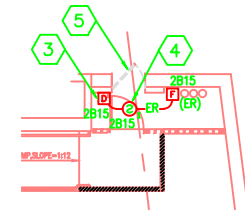

# DESIGN CRITERIA

56. CONSTRUCT A NEW 2 HOUR FIRE RESISTIVE ENTRY VESTIBULE AT THE SOUTHEAST CORNER OF THE SECOND LEVEL, WITHIN THE FOOTPRINT OF B50E.
178. PROVIDE ADDITIONAL EXIT SIGNS TO INDICATE THE DIRECTION OF EGRESS. NO POINT IN THE EXIT ACCESS TO BE MORE THAN 100 FEET FROM THE NEAREST VISIBLE SIGN.

1 FIRST FLOOR DEMO. & CONSTRUCTION PLAN  
SCALE: 1/16"=1'-0"

<div>CSS ARCHITECTS</div> <div>448 Eighth Street San Francisco, CA 94103 415 333-0333 415 333-1045 Fax</div>	CONSULTANT	REVISIONS	JOB TITLE	KEY PLAN	ESS ARCHITECTS JOB #: 9292	SHEET TITLE:
	MAZZETTI & ASSOCIATES, INC.	no. date description	FIRE AND SAFETY SYSTEMS UPGRADE	<div><div>REGISTERED PROFESSIONAL ENGINEER</div><div>WILLIAM P. MAZZETTI</div><div>No. 13450 EXP. 8/28/98</div><div>ELECTRICAL</div><div>STATE OF CALIFORNIA</div></div>	BUILDING 50E	
	Consulting Mechanical & Electrical Engineers	1 9/28/94 100% TITLE II 9/28/94	PHASE I		FIRST FLOOR	
	1000 BROADWAY STREET - SUITE 1000, SAN FRANCISCO, CA 94103-4071	2 11/7/94 TITLE II FINAL 2/13/95	LAWRENCE BERKELEY LABORATORY, UNIVERSITY OF CALIFORNIA		DEMO & CONSTRUCTION PLAN	
	TELEPHONE (415) 984-5000 FAX (415) 984-4303	3 3/30/95 REISSUE TITLE II FINAL 3/30/95	BERKELEY, CALIFORNIA		SCALE: AS NOTES DATE: 2/13/95	
F 021-205	4 9/20/95 FIRE AND LIFE SAFETY REV. 9/20/95				ACAD FILE NAME:	SHEET:
	5 7/25/97 AS BUILT 7/25/97				LBLN DWG: 3N50EE023F	50E-E2.1F
					PROJ # 120257	